F. A. RTE.	SECTION	COUNTY	TOTAL SHEETS	SHEET NO
80/94	2626.2-R-1	COOK	452	57
STA.		TO STA.		
FED. ROAD DIST. NO.	ILLINOIS	FED. AID PROJECT		


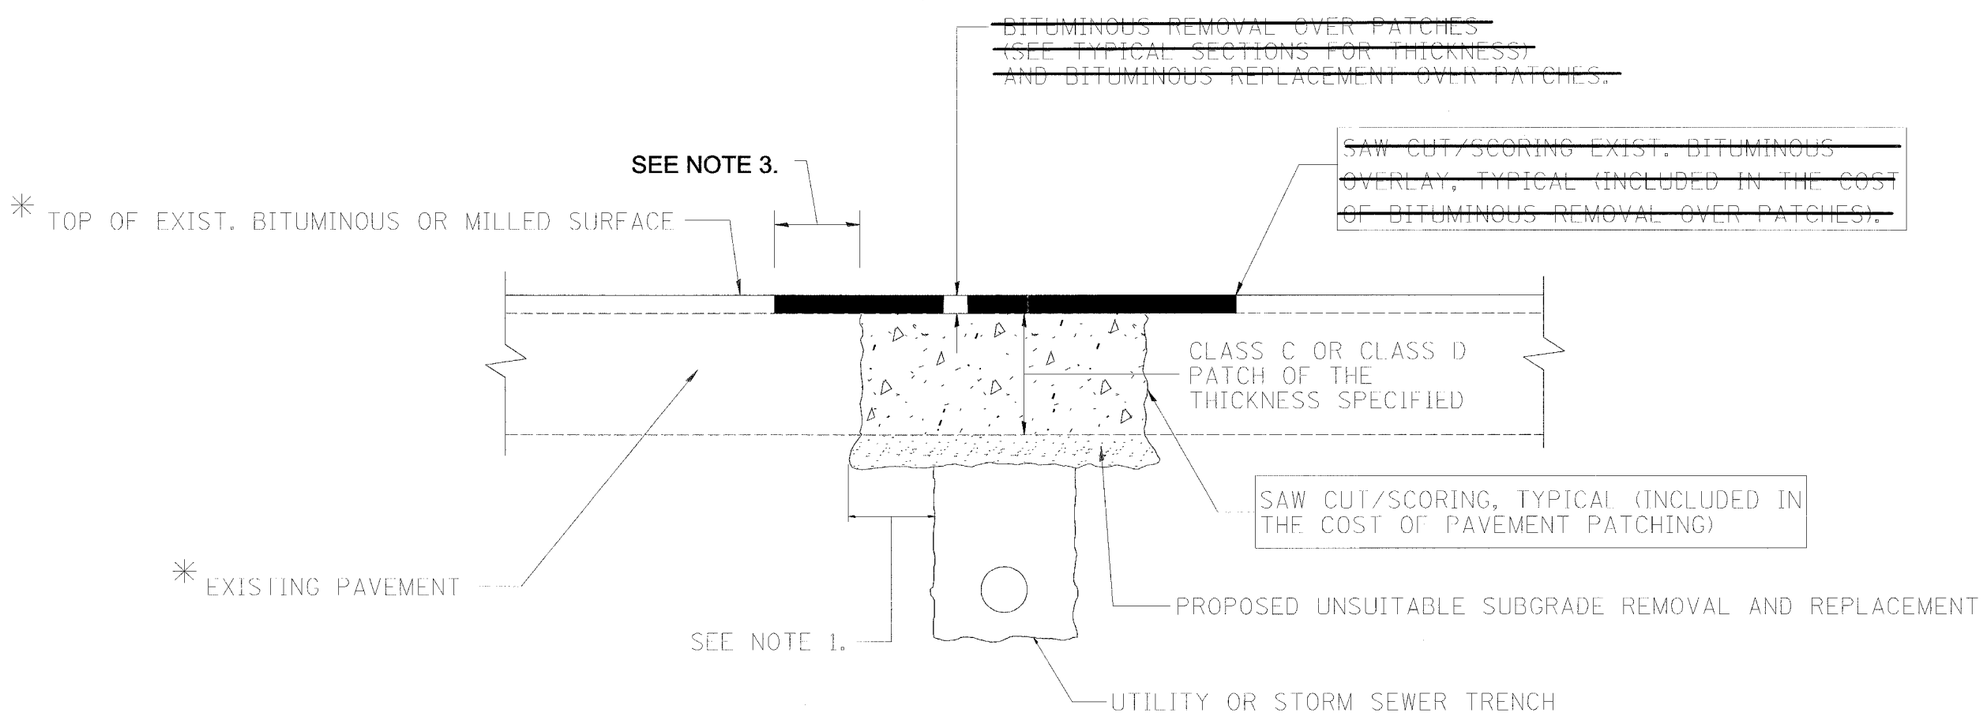

* SEE TYPICAL SECTIONS FOR THICKNESS AND MATERIALS

NOTES:

1. THE WIDTH OF THE FULL DEPTH PATCH OVER A TRENCH SHALL BE 300 (12) WIDER ON EACH SIDE OF THE TRENCH.

2. ~~FOR METHOD OF MEASUREMENT AND BASIS OF PAYMENT, SEE SPECIAL PROVISION "PATCHING WITH BITUMINOUS OVERLAY REMOVAL".~~

3. SAW CUT FULL DEPTH OF PATCH. DO NOT REMOVE OVERLAY BEYOND SAW CUT.

SEQUENCE OF CONSTRUCTION

1. ~~REMOVE THE EXISTING BITUMINOUS MATERIAL OVER THE AREA TO BE PATCHED.~~

2. REMOVE AND REPLACE FULL DEPTH PATCHES

3. ~~REPLACE BITUMINOUS MATERIAL OVER THE AREA TO BE PATCHED.~~

ALL DIMENSIONS ARE IN MILLIMETERS (INCHES) UNLESS OTHERWISE SHOWN.

REVISIONS		REVISIONS	
NAME	DATE	NAME	DATE
R. SHAH	10/25/94	ART ABBAS	04/27/98
R. SHAH	01/14/95		
R. SHAH	03/23/95		
R. SHAH	04/24/95		
A. HOUSEH	03/15/96		
A. ABBAS	03/21/97		
A. ABBAS	01/20/98		

ILLINOIS DEPARTMENT OF TRANSPORTATION

PAVEMENT PATCHING FOR BITUMINOUS SURFACED PAVEMENT

SCALE: NONE DRAWN BY

DATE $$DATE$$ CHECKED BY

VI=BD22
DGN-SPEC
DATE-TIME

BD400-04 (BD-22)