SHEET 35 of 59

66284

BOND ISSUE ROUTE NO.	SEC.	COUNTY	TOTAL SHEETS	SHEET NO.
89	*	PUTNAM MARSHALL	59	1
S. P. R. REQ. NO. 4	ILLINOIS	PROJECT		

* SEC. (122,123,124) W.&RS., 122BR.&105BR-1

P-93-007-71

ILLINOIS D.O.T.
OFFICE OF DISTRICT ENGINEER
700 E. NORRIS DRIVE
OTTAWA, ILL. 61350

STATE OF ILLINOIS
DEPARTMENT OF TRANSPORTATION
DIVISION OF HIGHWAYS

As Built

PLANS FOR PROPOSED
STATE BOND ISSUE HIGHWAY

SCALE IN FEET

PLAN 0 100 200 — PROFILE VERT. 0 10 20

PROFILE HOR. 0 100 200 — CROSS-SECTIONS 0 5 10

S.B.I. ROUTE 89
SECTION (122,123,124) W.&RS., (122 BR. & 105 BR-1)
PUTNAM & MARSHALL COUNTIES

C-93-095-71

INDEX OF SHEETS

Sheet No.	Title
1	Title Sheet
2	Summary of Quantities
	Roadway Section
3-4	Typical Sections
5	Summary of Quantities - Roadway Section
6-7	Schedule of Quantities
8	Plan And Profile - Varna
9	Plan, Rt. 17 Intersection
10	Detail, Type "S" Rail
11	Bridge Repair Details
12-19	Signing Details
20	Cross Sections - Varna
21	Cross Sections - Rt. 17 Radials
	Bridge Section
22-23	Typical Sections
24	Summary of Quantities - Bridge Section
25	Schedule of Quantities
26-29	Plan And Profile
30-31	Detour
32-38	Structure Plans - Sta. 565+81
39-45	Structure Plans - Sta. 425+08
46-51	Cross Sections - Bridge Sta. 565+81
52-54	Cross Sections - Bridge Sta. 425+08
55	Cross Sections - Detour
56-57	Cross Sections - Channel
58-59	Traffic Control - Special
	STANDARDS
1686-3	Symbols
1690	Grading At Trees
1744-2	Right of Way Markers
2113-1	Name Plates
2115-3	Pavement Fabric
2117-1	Patching Details
2122-4	Concrete Medians
2130-3	Curb And Gutter
2143-3	Width Transition
2149-9	Delineators
2171	Mail Box Turnouts
2228-2	Metal End Sections
2229-2	Metal End Sections (Arch)
2230-7	S. P. B. G. R.
2231-3	S. P. B. G. R.
2256-4	Break-Away Sign Posts
2298-3	Barricades And Signs
2299-4	Barricades, Cones And Drums
2300	Flagman Sign
2301-2	Traffic Control
2302-2	Traffic Control
2303-3	Traffic Control
2304-2	Traffic Control
2305-2	Traffic Control
2306-3	Traffic Control
2307-3	Traffic Control
2311-3	Traffic Control
2319-1	Sign Mount Details
2320-3	Sign Erection Details
2309-2	TRAFFIC CONTROL
2258-1	Paved Ditch
2325-1	S.P.B.G.R.
2326	S.P.B.G.R.

LOCATION OF SECTION INDICATED THUS:—

AREA SERVICE: ADT 1982 = 1750

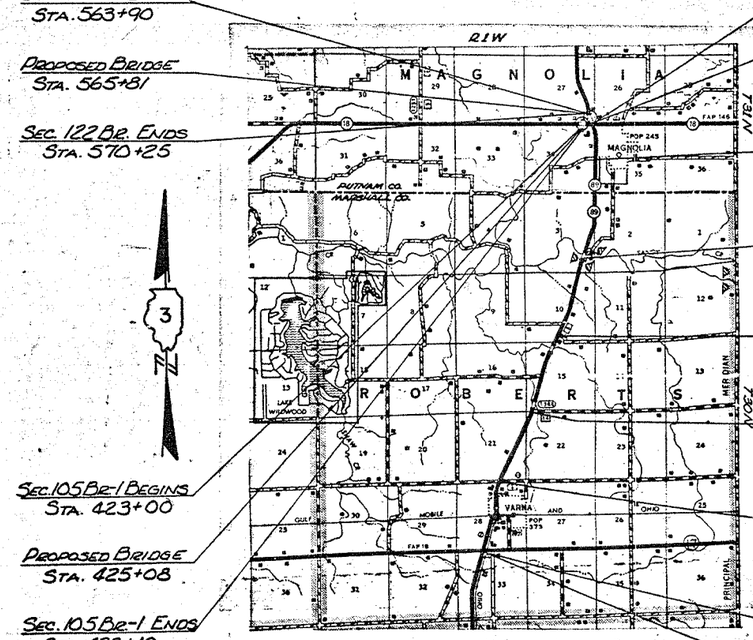

Sec. 122 Br. Begins
Sta. 563+90

Proposed Bridge
Sta. 565+81

Sec. 122 Br. Ends
Sta. 570+25

Sec. 105 Br-1 Begins
Sta. 423+00

Proposed Bridge
Sta. 425+08

Sec. 105 Br-1 Ends
Sta. 428+10

INT. RT. 89 & RT. 18 =
LOG MILE 0.00

W.&RS. BEGINS
LOG MILE 0.06

LOG MILE 0.44

OMISSION For BRIDGE
LOG MILE 1.80 To LOG MILE 1.91

LOG MILE 2.97

LOG MILE 4.32

LOG MILE 5.47

W.&RS. ENDS
LOG MILE 6.52

INT. RT. 89 & RT. 17 =
LOG MILE 6.55

NET LENGTH OF (Sec. 122 Br.) SBI Rt. 89 = 635 Ft. = 0.120 Mi.
(Sec. 105 Br-1) SBI Rt. 89 = 510 Ft. = 0.097 Mi.

NET LENGTH OF JOB = 6.657 MILES

GROSS LENGTH OF JOB = 6.767 MILES

STATE OF ILLINOIS
DEPARTMENT OF TRANSPORTATION

SUBMITTED 5/18 19 73 — DISTRICT ENGINEER

EXAMINED July 2 19 73 — ENGINEER OF PLANS AND LOCATION

PASSED July 2 19 73 — ENGINEER OF DESIGN

APPROVED JULY 2 19 73 — ACTING CHIEF TRANSPORTATION ENGINEER

DIVISION ENGINEER — DATE

CONTRACT NO. 29631